

Creative Union Network Inc.
 113 Wolseley Street
 Toronto, Ontario
 M6J 1K1
 phone: 416 839 7940

THE INFORMATION CONTAINED IN THIS DRAWING IS THE
 SOLE PROPERTY OF CREATIVE UNION NETWORK INC. ANY
 REPRODUCTIONS IN PART OR IN WHOLE WITHOUT THE
 WRITTEN PERMISSION OF CREATIVE UNION NETWORK INC. IS
 PROHIBITED




PROJECT NO. 2019 - P112

PROJECT ADDRESS
 44 Wilson Park Road
 Toronto, Ontario
 M6K 3B5

AS-BUILT

Date Issued for

LEGEND

- EXISTING STRUCTURE 
- PROPOSED 
- DEMOLITION 

GENERAL NOTES:


DRAWING NOT TO BE SCALED

ANY SITE CONDITIONS THAT DIFFER FROM THOSE SHOWN
 SHOULD BE REPORTED TO CREATIVE UNION NETWORK INC.
 PRIOR TO CONSTRUCTION


Drawn	CB	Checked	TM
Scale	3/16" = 1'-0"	Sheet size	Tabloid

BASEMENT FLOOR PLAN

E-100

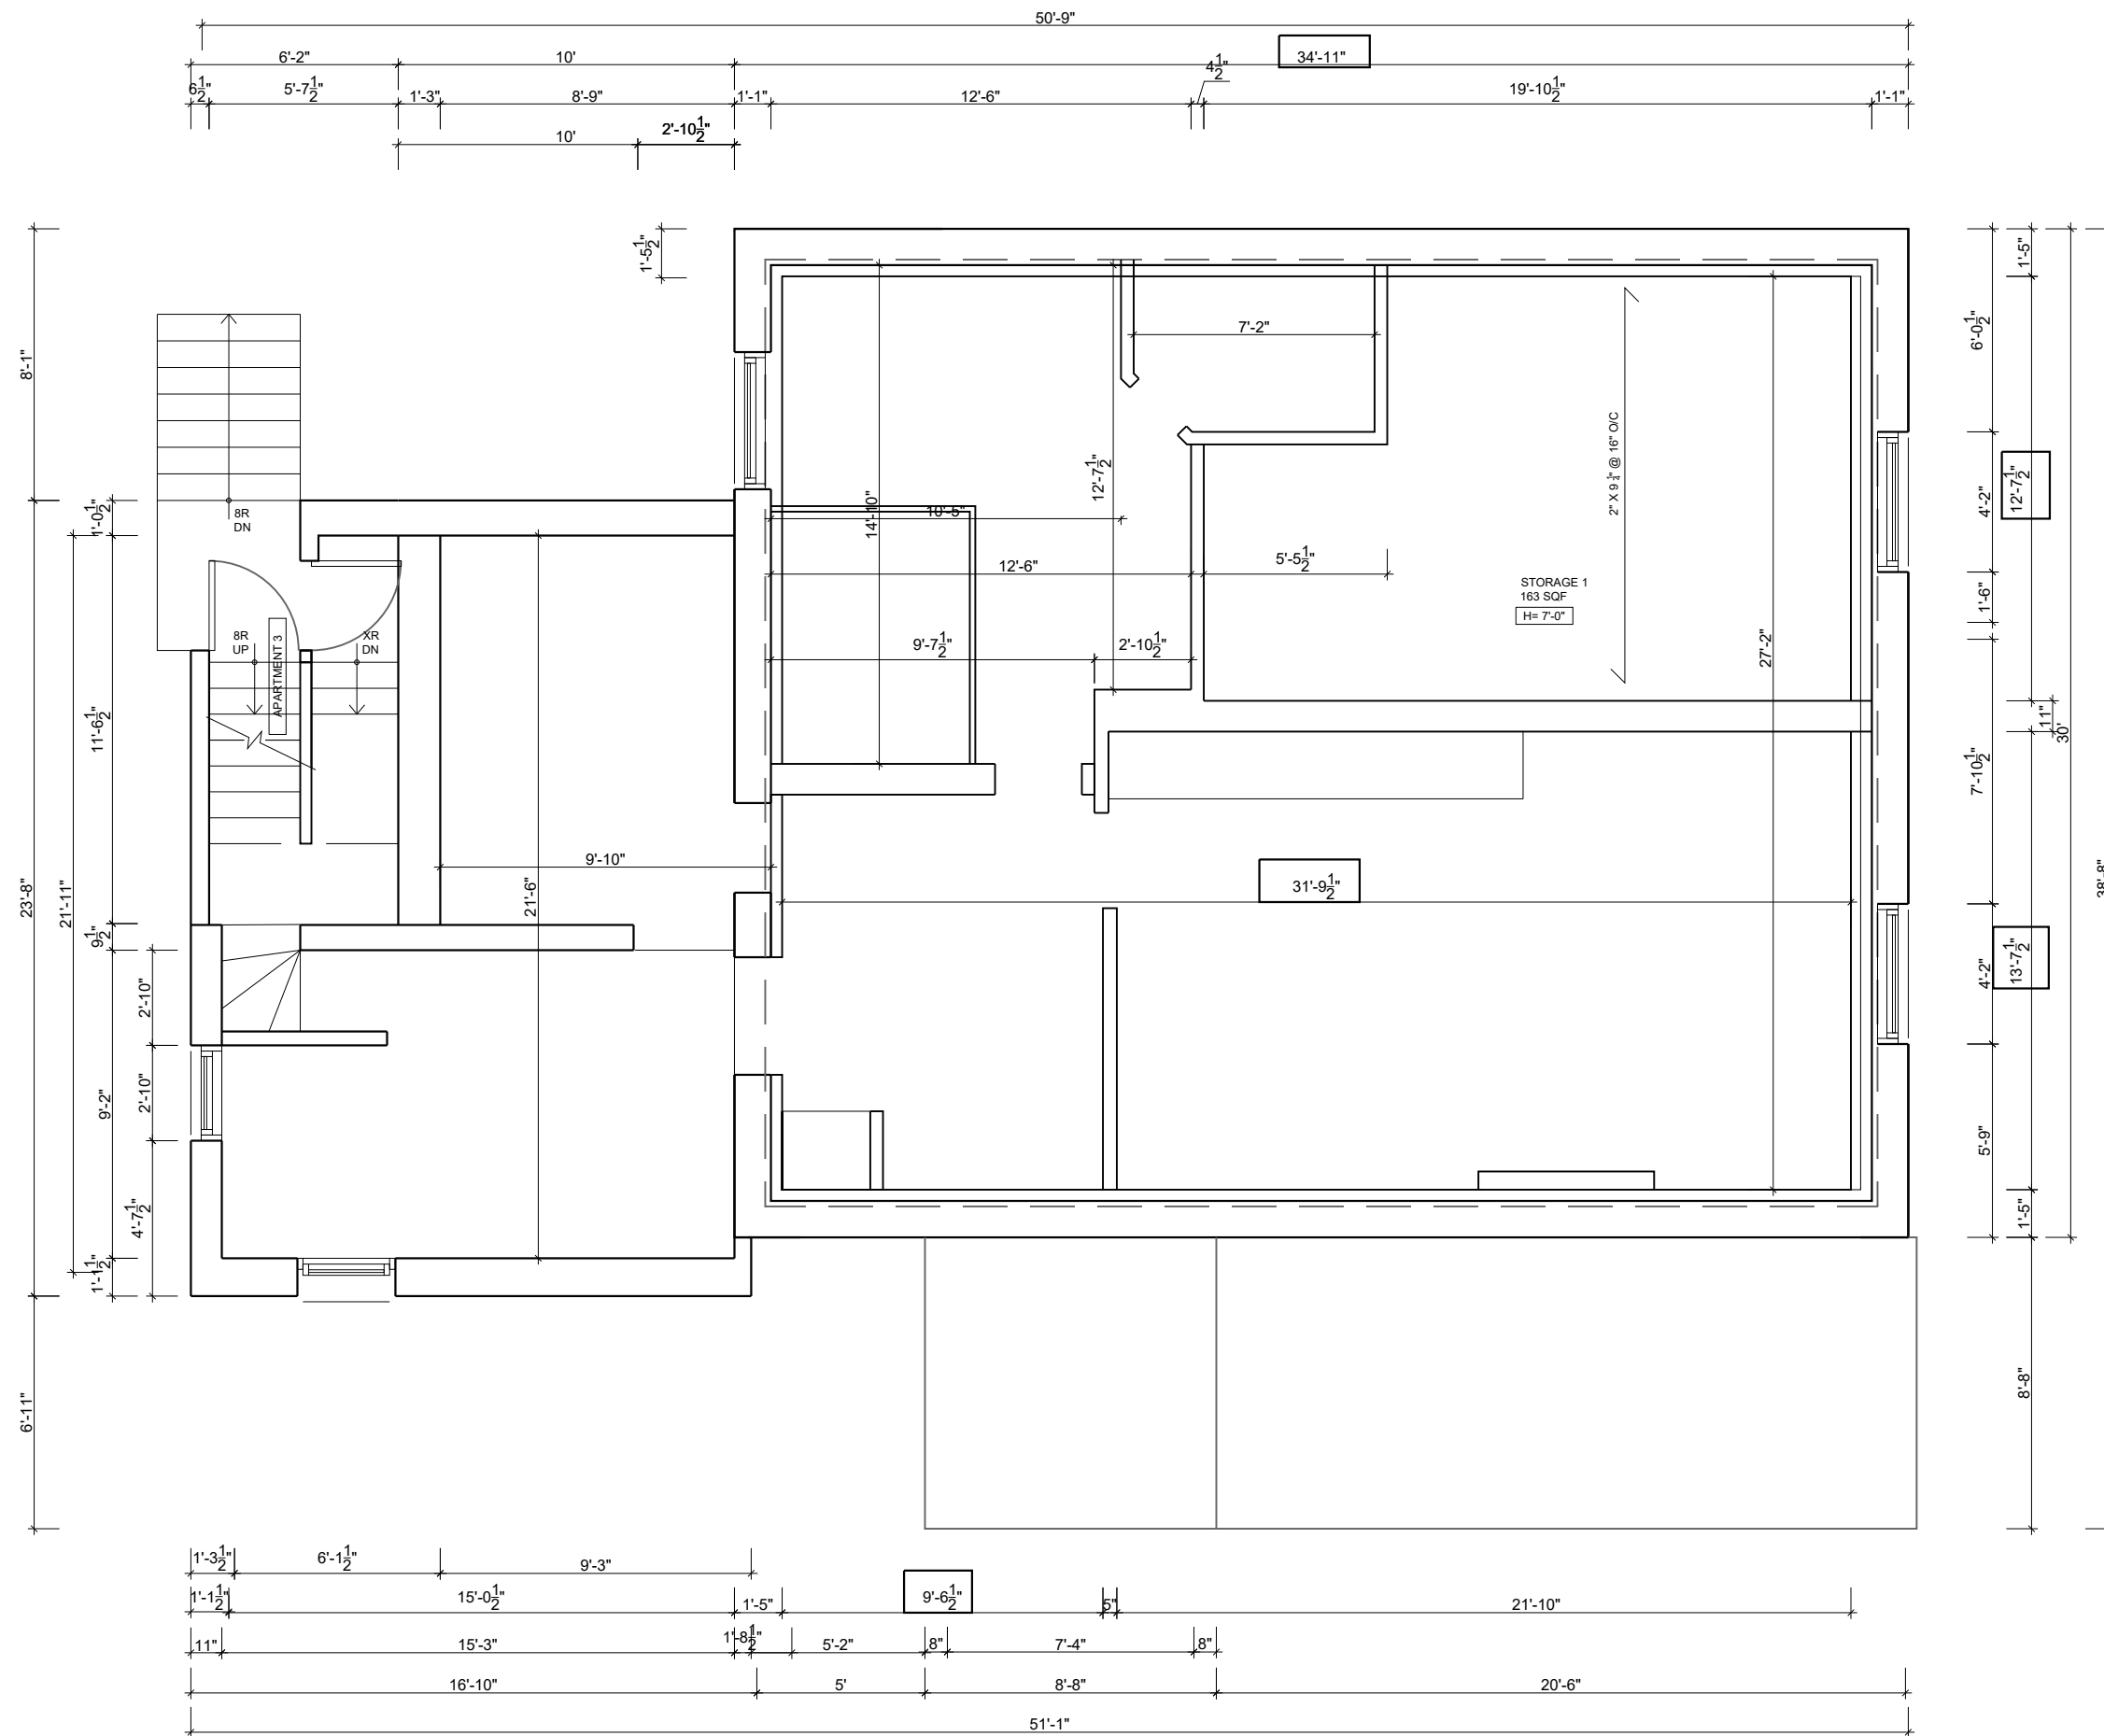

THE INFORMATION CONTAINED IN THIS DRAWING IS THE SOLE PROPERTY OF CREATIVE UNION NETWORK INC. ANY REPRODUCTIONS IN PART OR IN WHOLE WITHOUT THE WRITTEN PERMISSION OF CREATIVE UNION NETWORK INC. IS PROHIBITED

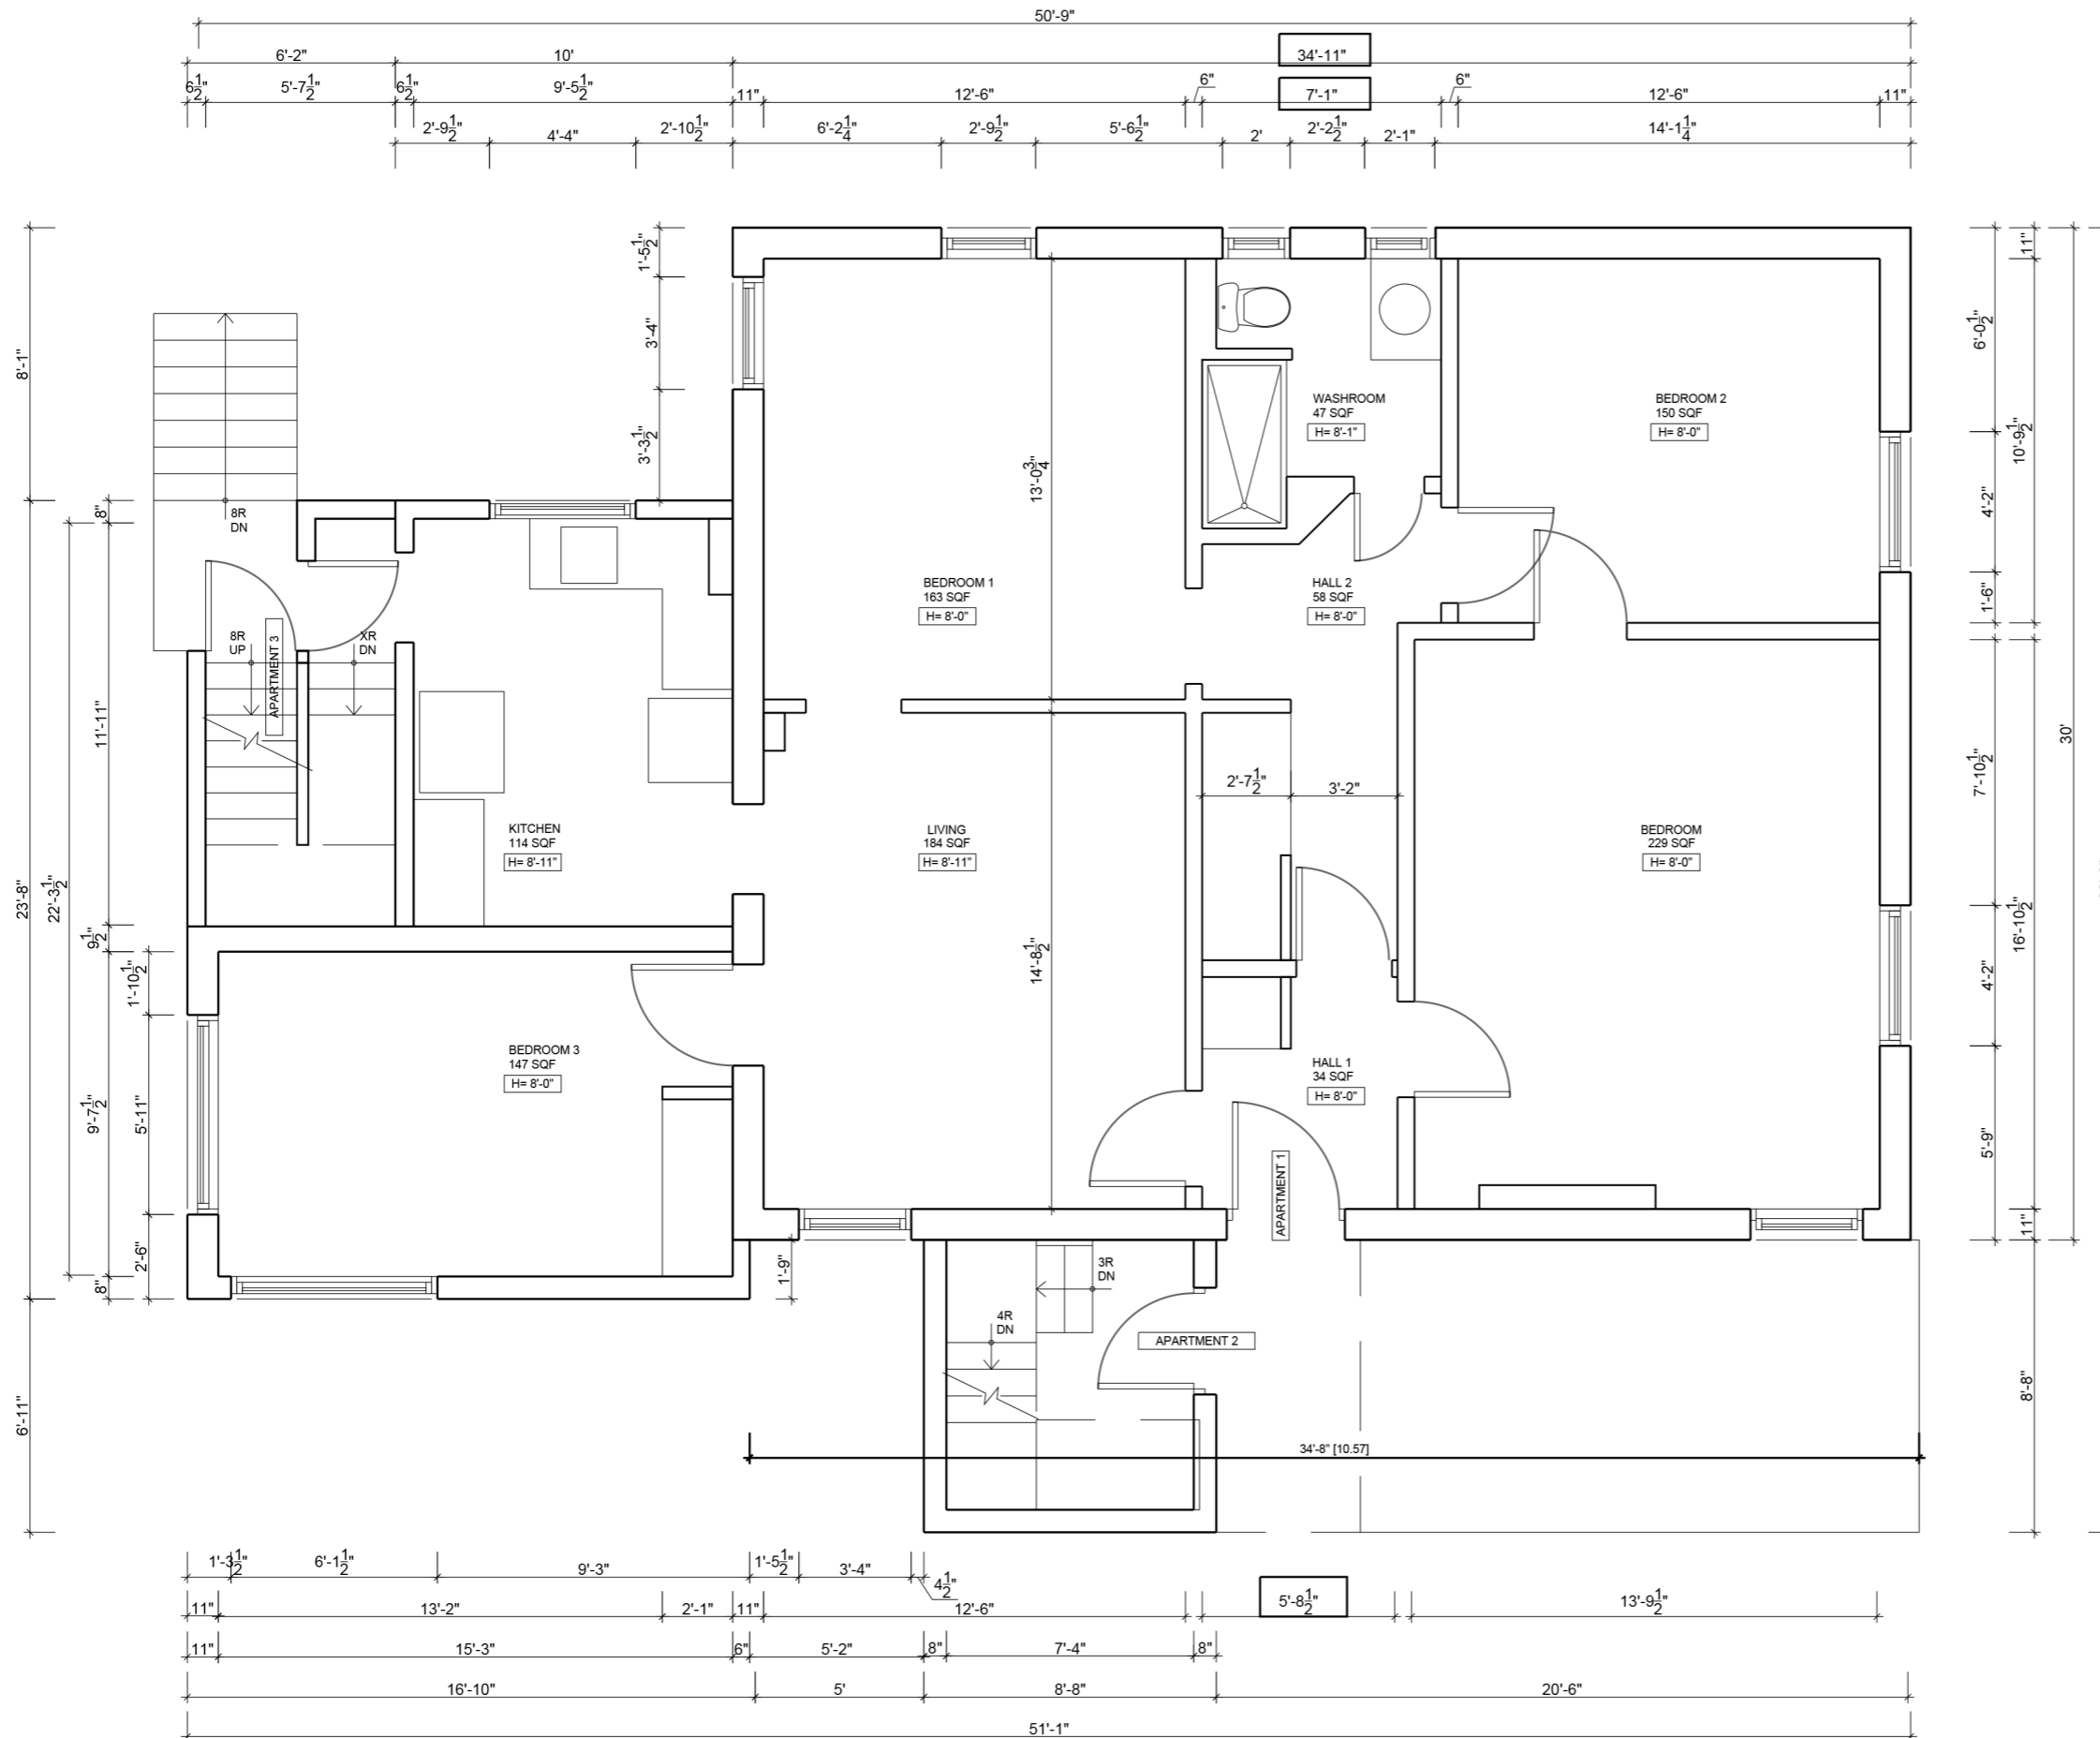

PROJECT NO. 2019 - P112

PROJECT ADDRESS

44 Wilson Park Road
Toronto, Ontario
M6K 3B5

AS-BUILT

Date	Issued for

LEGEND

- EXISTING STRUCTURE
- PROPOSED
- DEMOLITION

GENERAL NOTES:

DRAWING NOT TO BE SCALED

ANY SITE CONDITIONS THAT DIFFER FROM THOSE SHOWN SHOULD BE REPORTED TO CREATIVE UNION NETWORK INC. PRIOR TO CONSTRUCTION

Drawn	CB	Checked	TM
Scale	3/16" = 1'-0"	Sheet size	Tabloid

GROUND FLOOR PLAN

E-110

Creative Union Network Inc.
 113 Wolseley Street
 Toronto, Ontario
 M6J 1K1
 phone: 416 839 7940

THE INFORMATION CONTAINED IN THIS DRAWING IS THE SOLE PROPERTY OF CREATIVE UNION NETWORK INC. ANY REPRODUCTIONS IN PART OR IN WHOLE WITHOUT THE WRITTEN PERMISSION OF CREATIVE UNION NETWORK INC. IS PROHIBITED




PROJECT NO. 2019 - P112

PROJECT ADDRESS
 44 Wilson Park Road
 Toronto, Ontario
 M6K 3B5

AS-BUILT

Date Issued for

LEGEND

EXISTING STRUCTURE 
 PROPOSED 
 DEMOLITION 

GENERAL NOTES:


DRAWING NOT TO BE SCALED

ANY SITE CONDITIONS THAT DIFFER FROM THOSE SHOWN SHOULD BE REPORTED TO CREATIVE UNION NETWORK INC. PRIOR TO CONSTRUCTION

Drawn	CB	Checked	TM
Scale	3/16" = 1'-0"	Sheet size	Tabloid

SECOND FLOOR PLAN

E-120

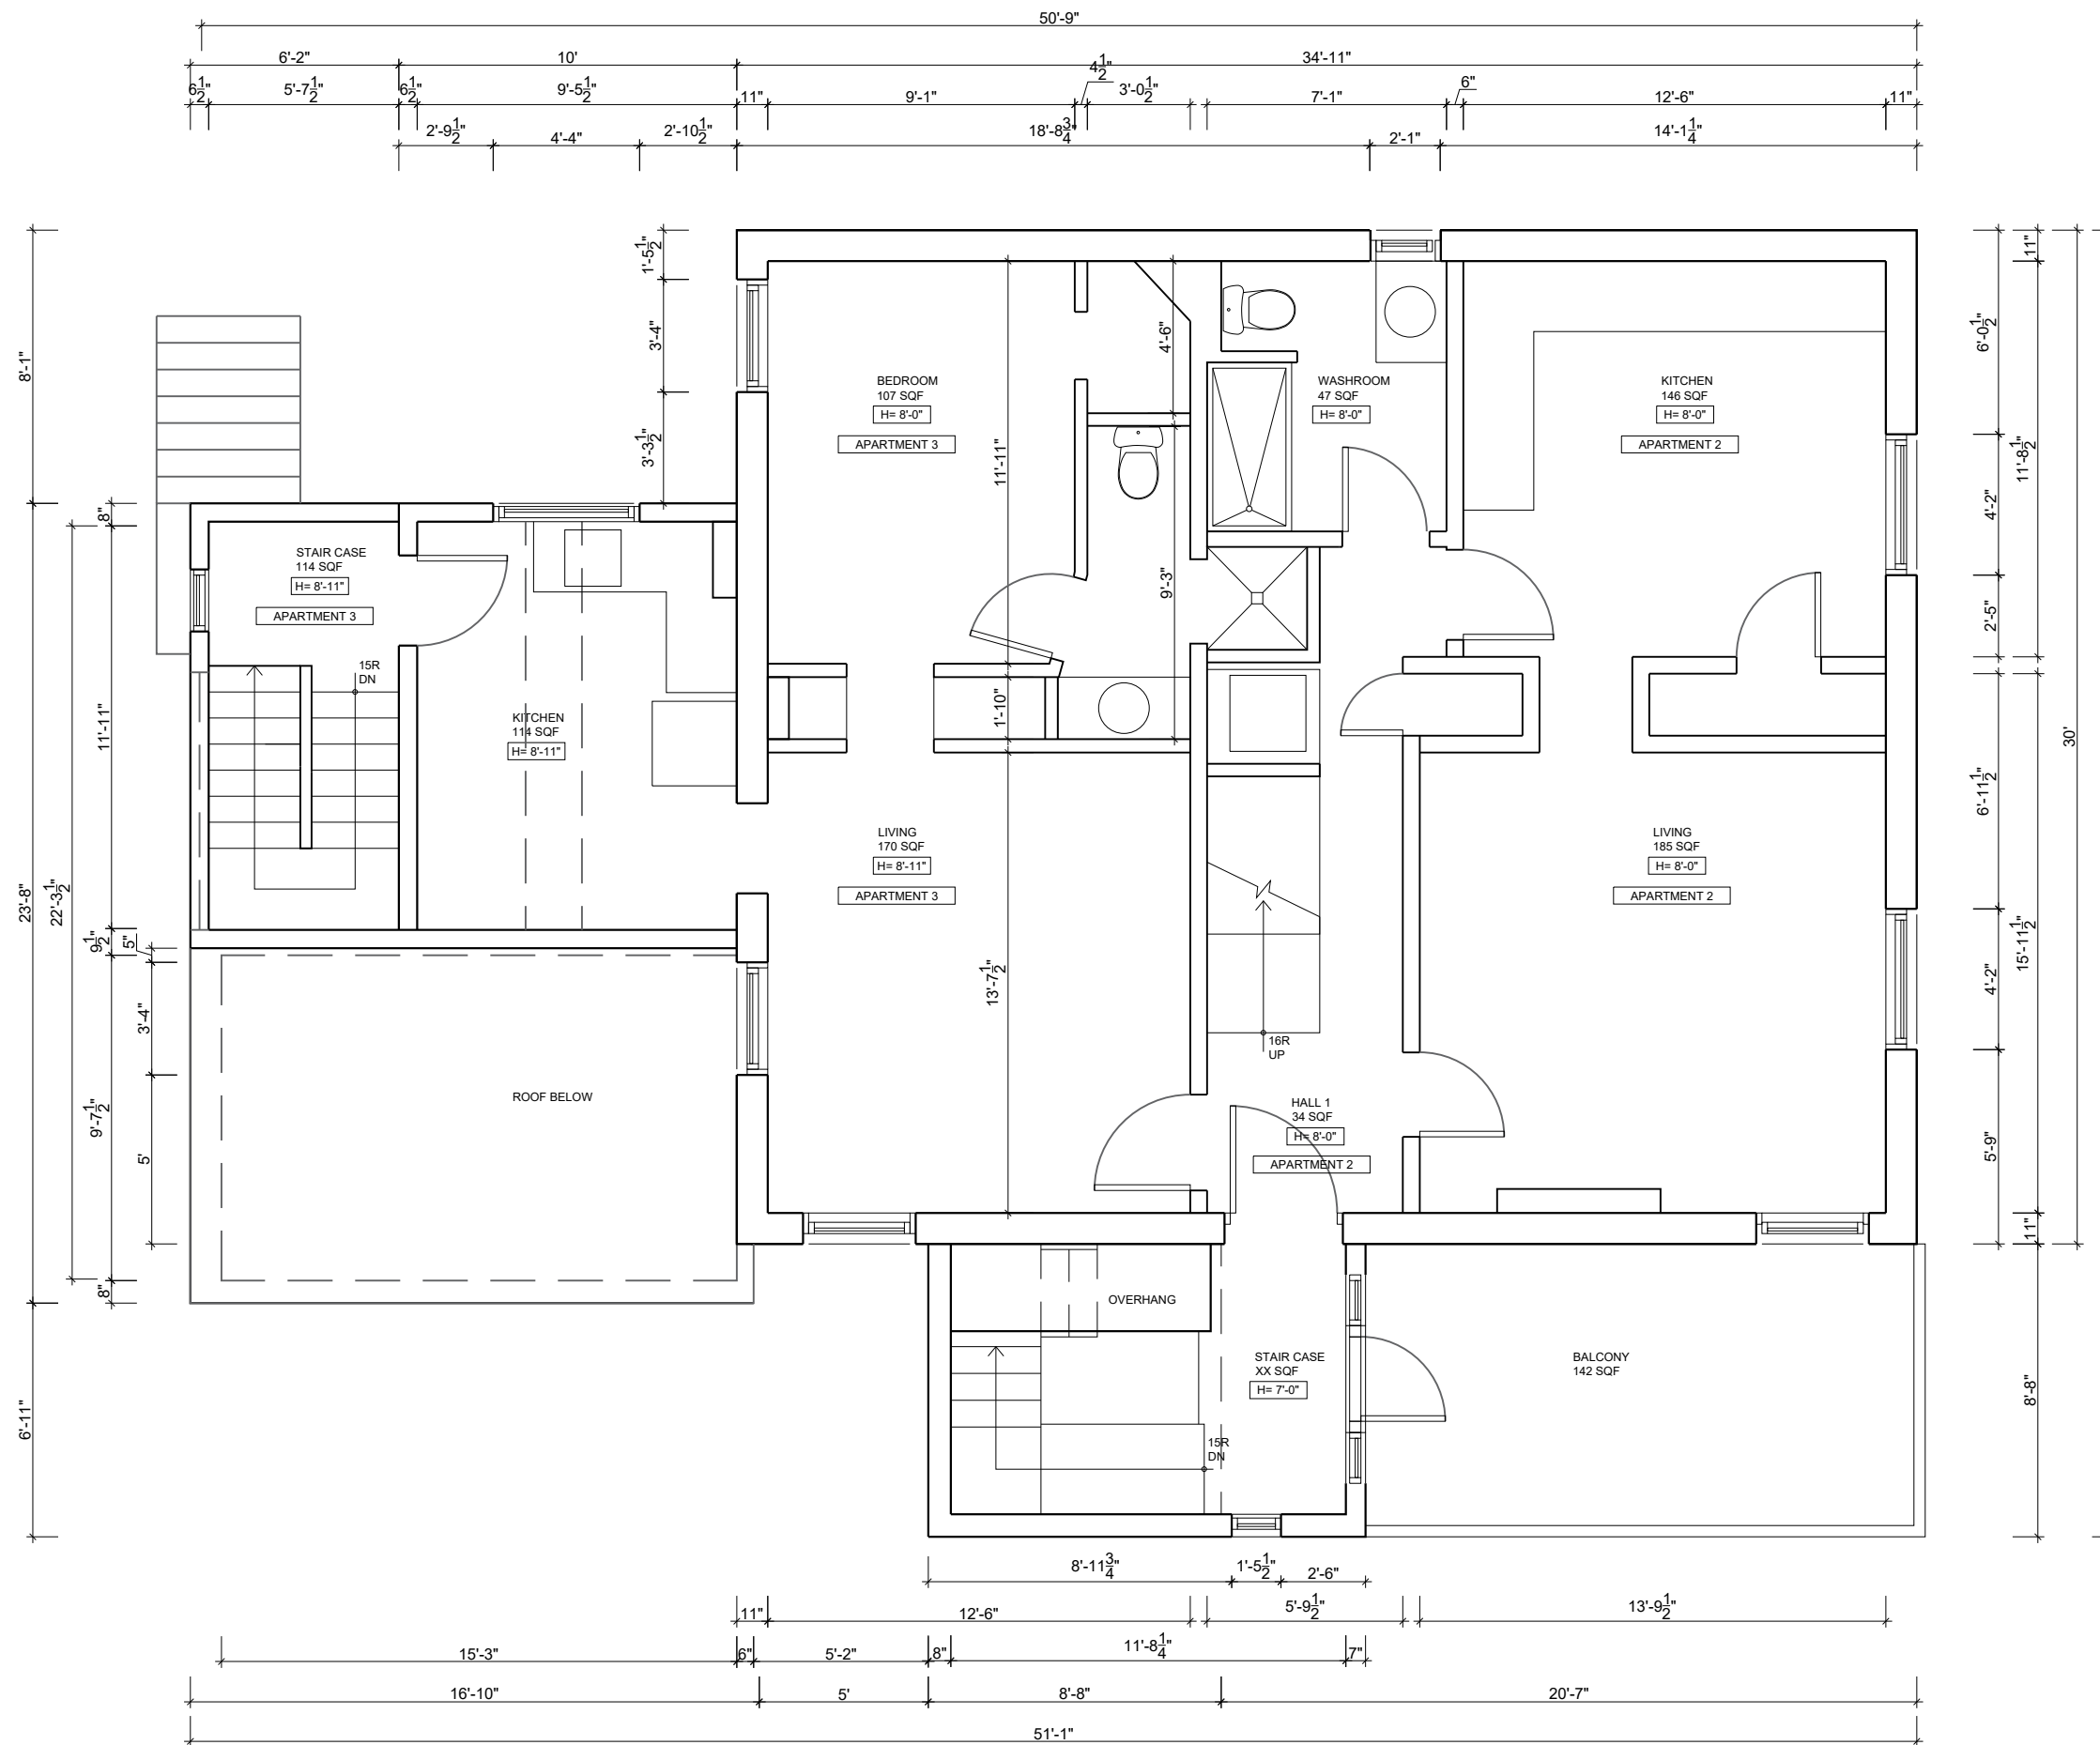

Creative Union Network Inc.
 113 Wolseley Street
 Toronto, Ontario
 M6J 1K1
 phone: 416 839 7940

THE INFORMATION CONTAINED IN THIS DRAWING IS THE SOLE PROPERTY OF CREATIVE UNION NETWORK INC. ANY REPRODUCTIONS IN PART OR IN WHOLE WITHOUT THE WRITTEN PERMISSION OF CREATIVE UNION NETWORK INC. IS PROHIBITED


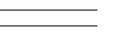
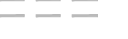
PROJECT NO. 2019 - P112

PROJECT ADDRESS
 44 Wilson Park Road
 Toronto, Ontario
 M6K 3B5

AS-BUILT

Date	Issued for
------	------------

LEGEND

EXISTING STRUCTURE	
PROPOSED	
DEMOLITION	

GENERAL NOTES:


DRAWING NOT TO BE SCALED

ANY SITE CONDITIONS THAT DIFFER FROM THOSE SHOWN SHOULD BE REPORTED TO CREATIVE UNION NETWORK INC. PRIOR TO CONSTRUCTION

Drawn	CB	Checked	TM
Scale	3/16" = 1'-0"	Sheet size	Tabloid

THIRD FLOOR PLAN

E-130

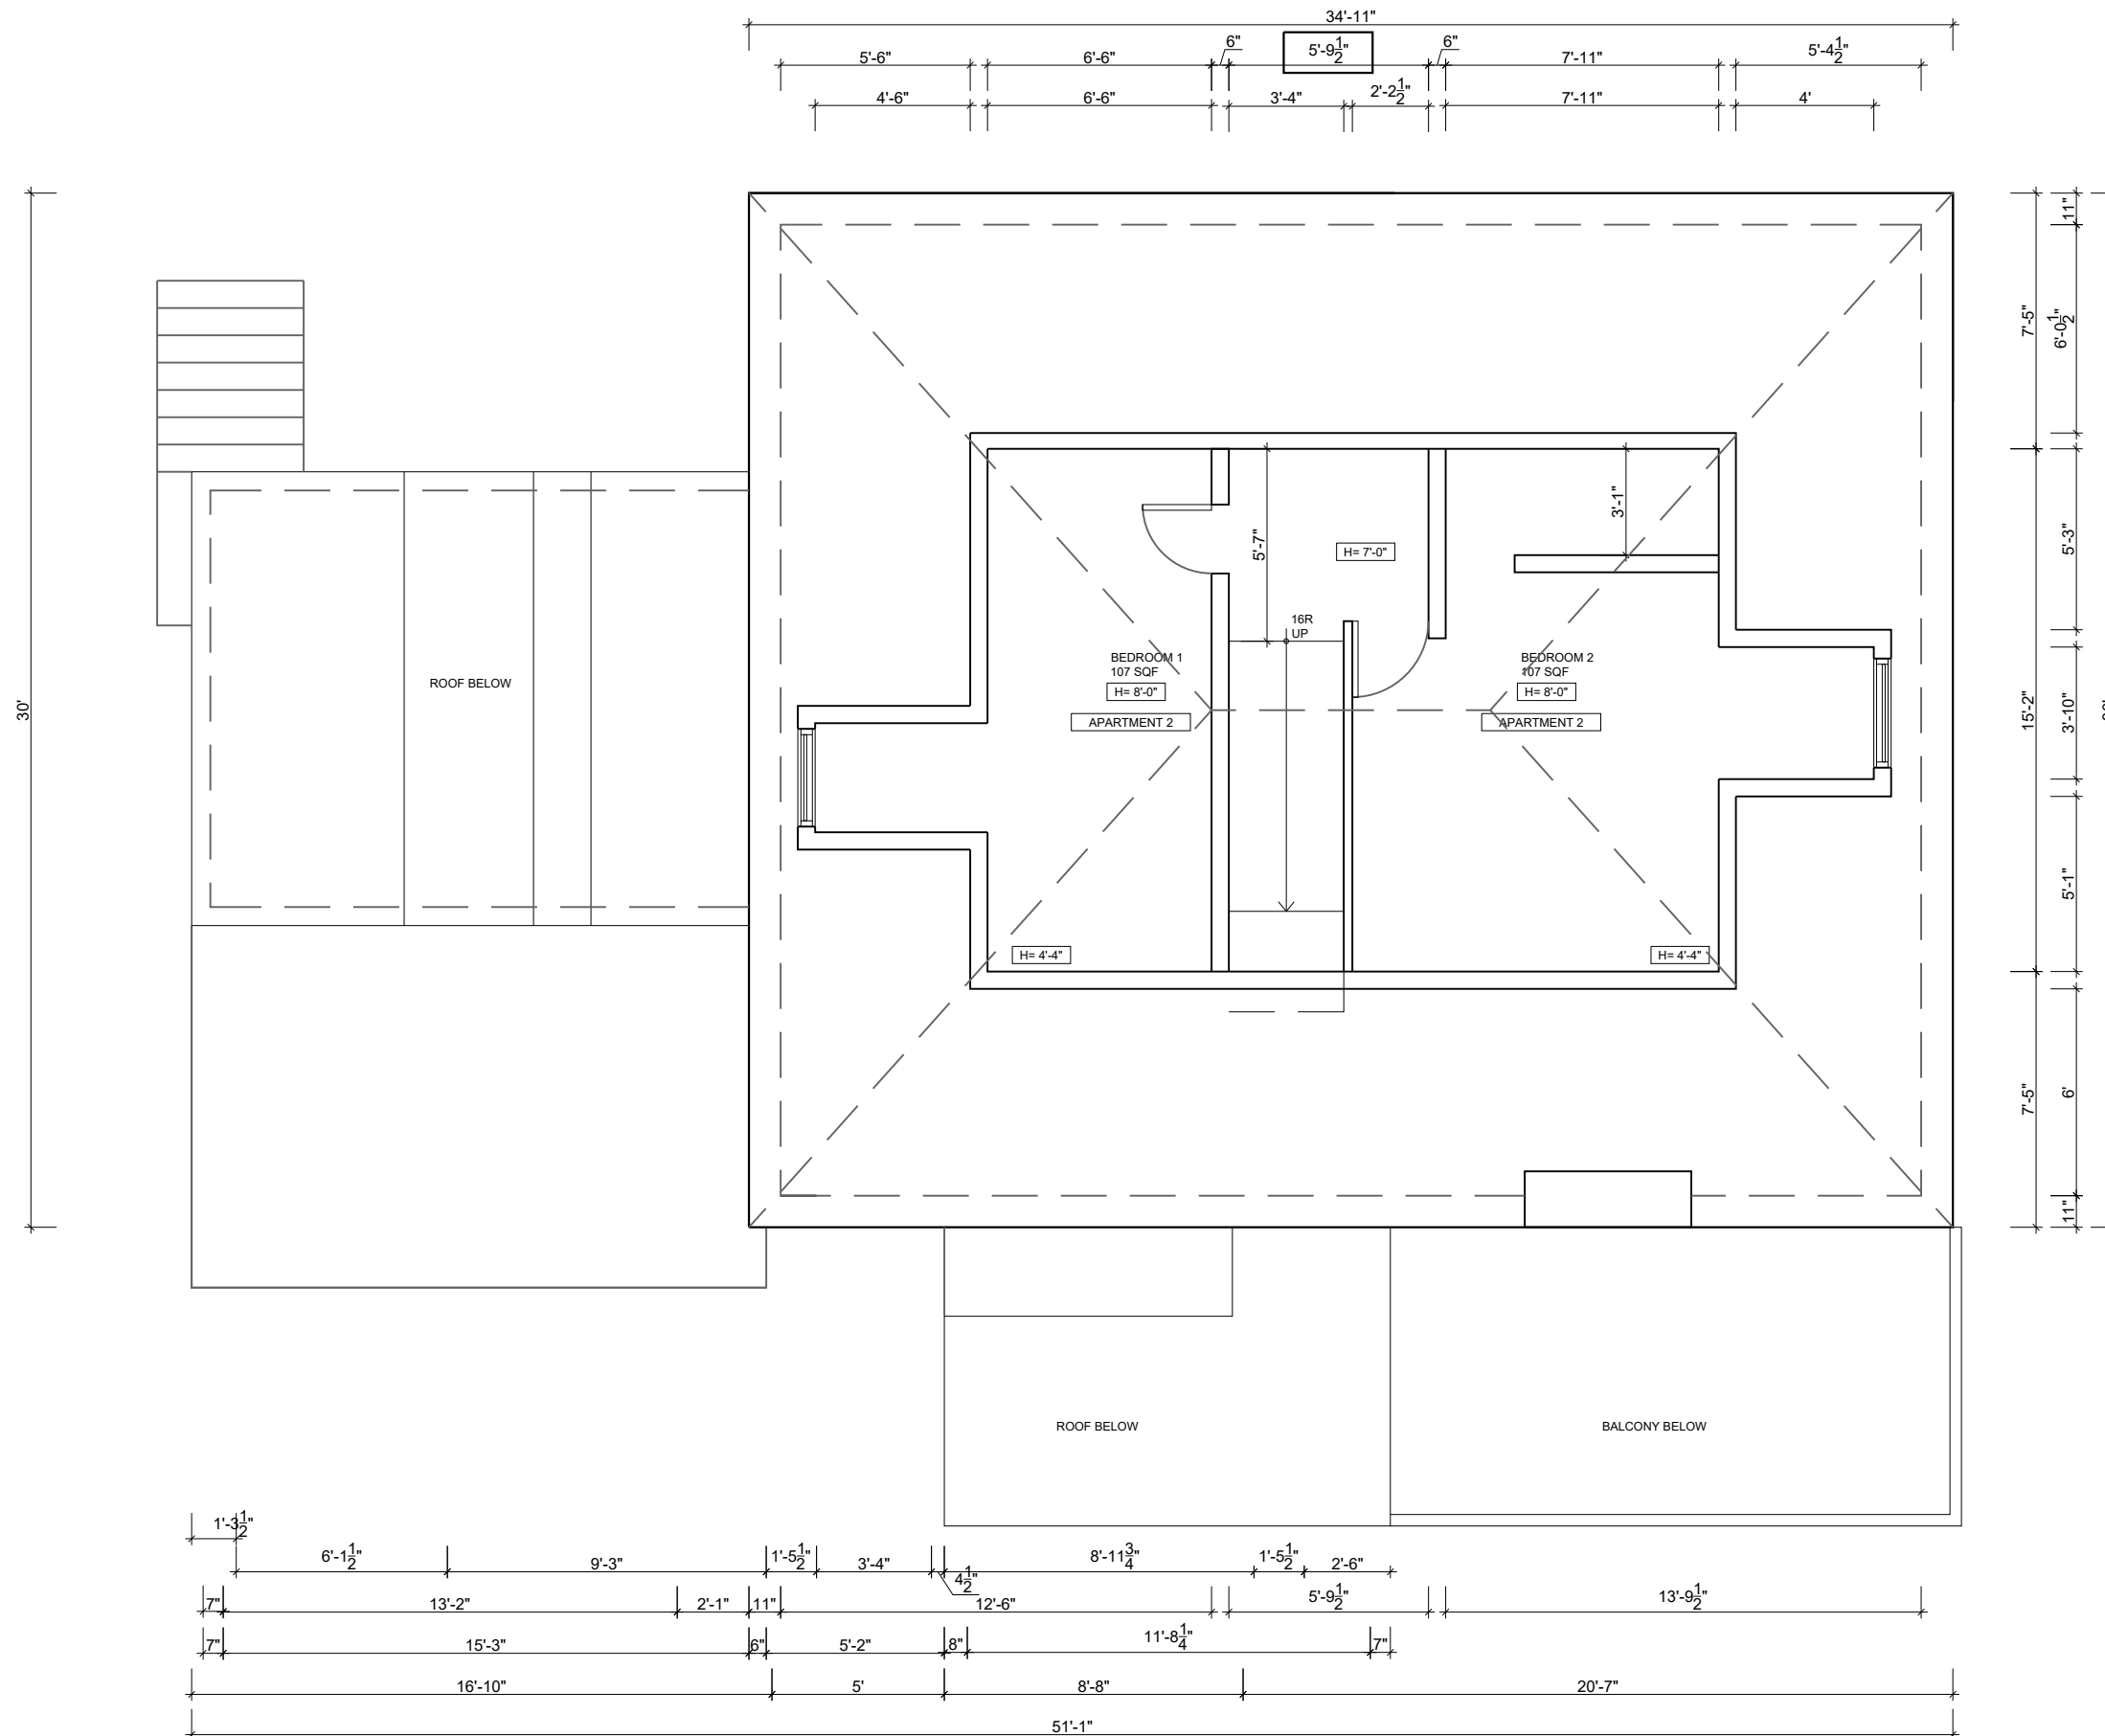

Creative Union Network Inc.
113 Wolseley Street
Toronto, Ontario
M6J 1K1
phone: 416 839 7940

THE INFORMATION CONTAINED IN THIS DRAWING IS THE
SOLE PROPERTY OF CREATIVE UNION NETWORK INC. ANY
REPRODUCTIONS IN PART OR IN WHOLE WITHOUT THE
WRITTEN PERMISSION OF CREATIVE UNION NETWORK INC. IS
PROHIBITED


PROJECT NO. 2019 - P112


PROJECT ADDRESS
44 Wilson Park Road
Toronto, Ontario
M6K 3B5


AS-BUILT

Date	Issued for
------	------------

LEGEND

EXISTING STRUCTURE 

PROPOSED 

DEMOLITION 

GENERAL NOTES:

DRAWING NOT TO BE SCALED

ANY SITE CONDITIONS THAT DIFFER FROM THOSE SHOWN
SHOULD BE REPORTED TO CREATIVE UNION NETWORK INC.
PRIOR TO CONSTRUCTION

Drawn	CB	Checked	TM
Scale	3/16" = 1'-0"	Sheet size	Tabloid

ROOF PLAN

E-140